





**1** South Elevation  
1 : 100

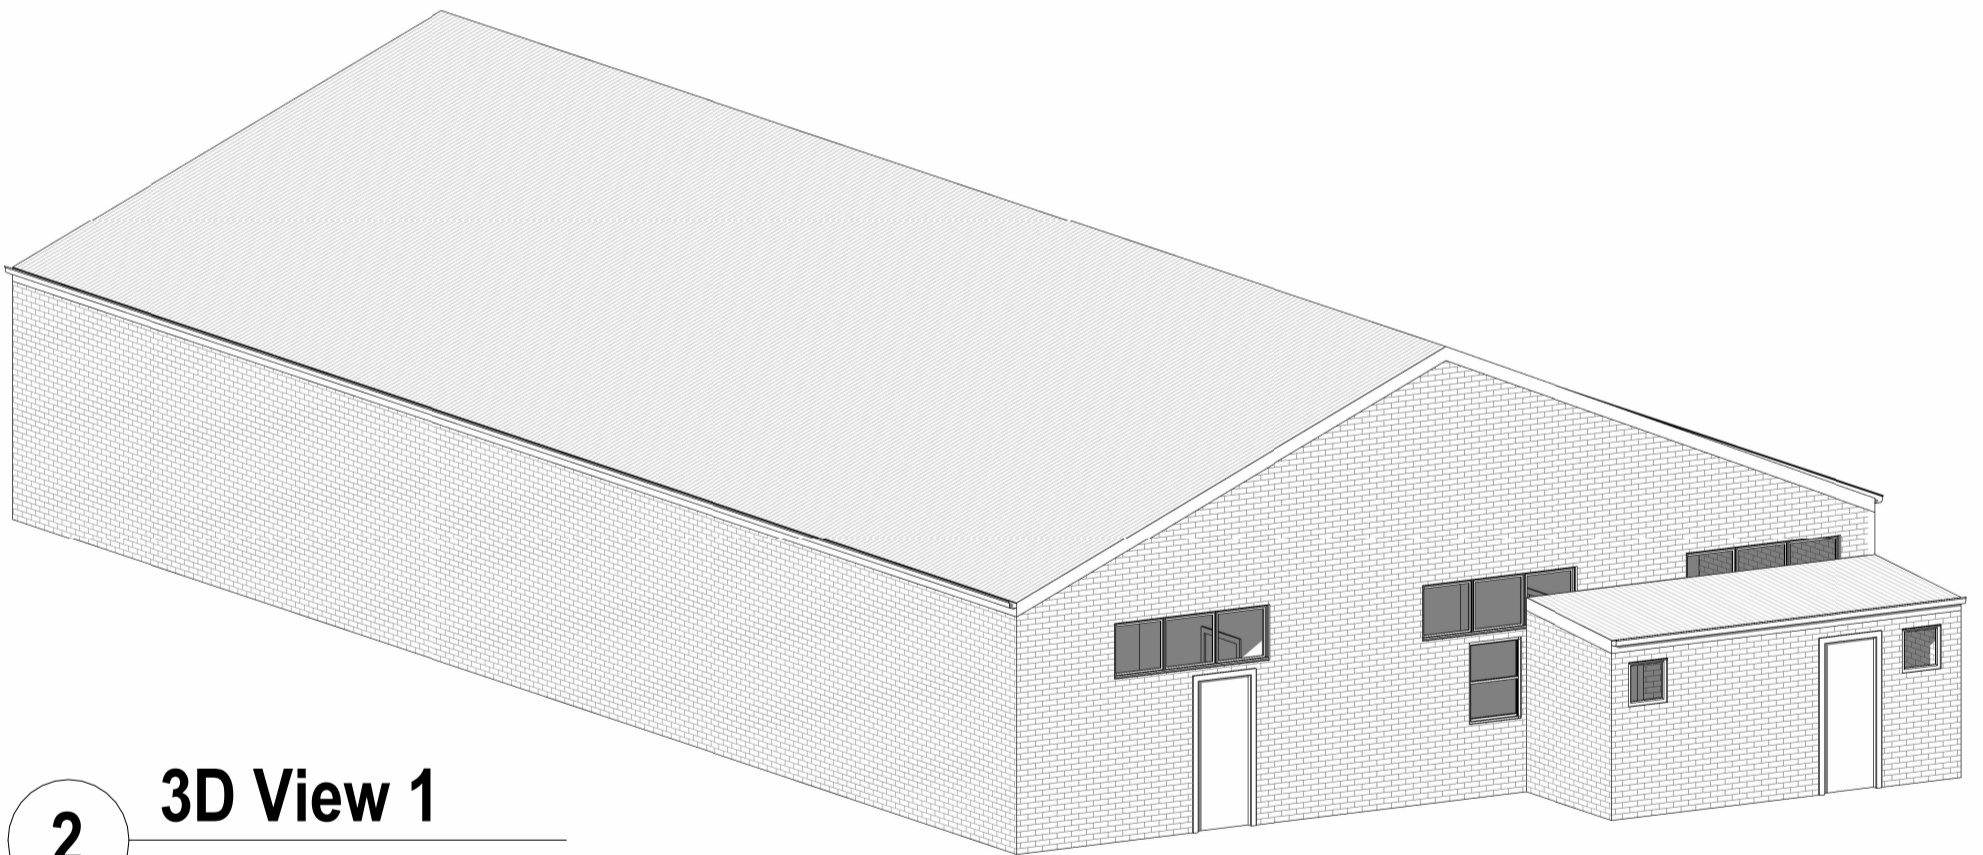

**2** 3D View 1

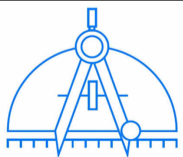

**MARSHALL**  
DRAFTING SERVICES  
20 Kuranda Avenue  
Armidale NSW 2350  
M: 0438 770 279  
E: marshalldrafting@gmail.com

No.	Description	Date
A	Client Issue	03.02.24
B	Client Issue	22.04.24

R. Burnet  
**As-built Attached Dwelling**  
46 Bridge Street  
Uralla NSW 2358

**South Elevation & 3D View**

Project Number	24015	<b>WD-04</b>	<b>B</b>
Date	03/02/2024		
Drawn by	C. Marshall	Scale	1 : 100
Checked by	C. Marshall		