



# Bridge Street

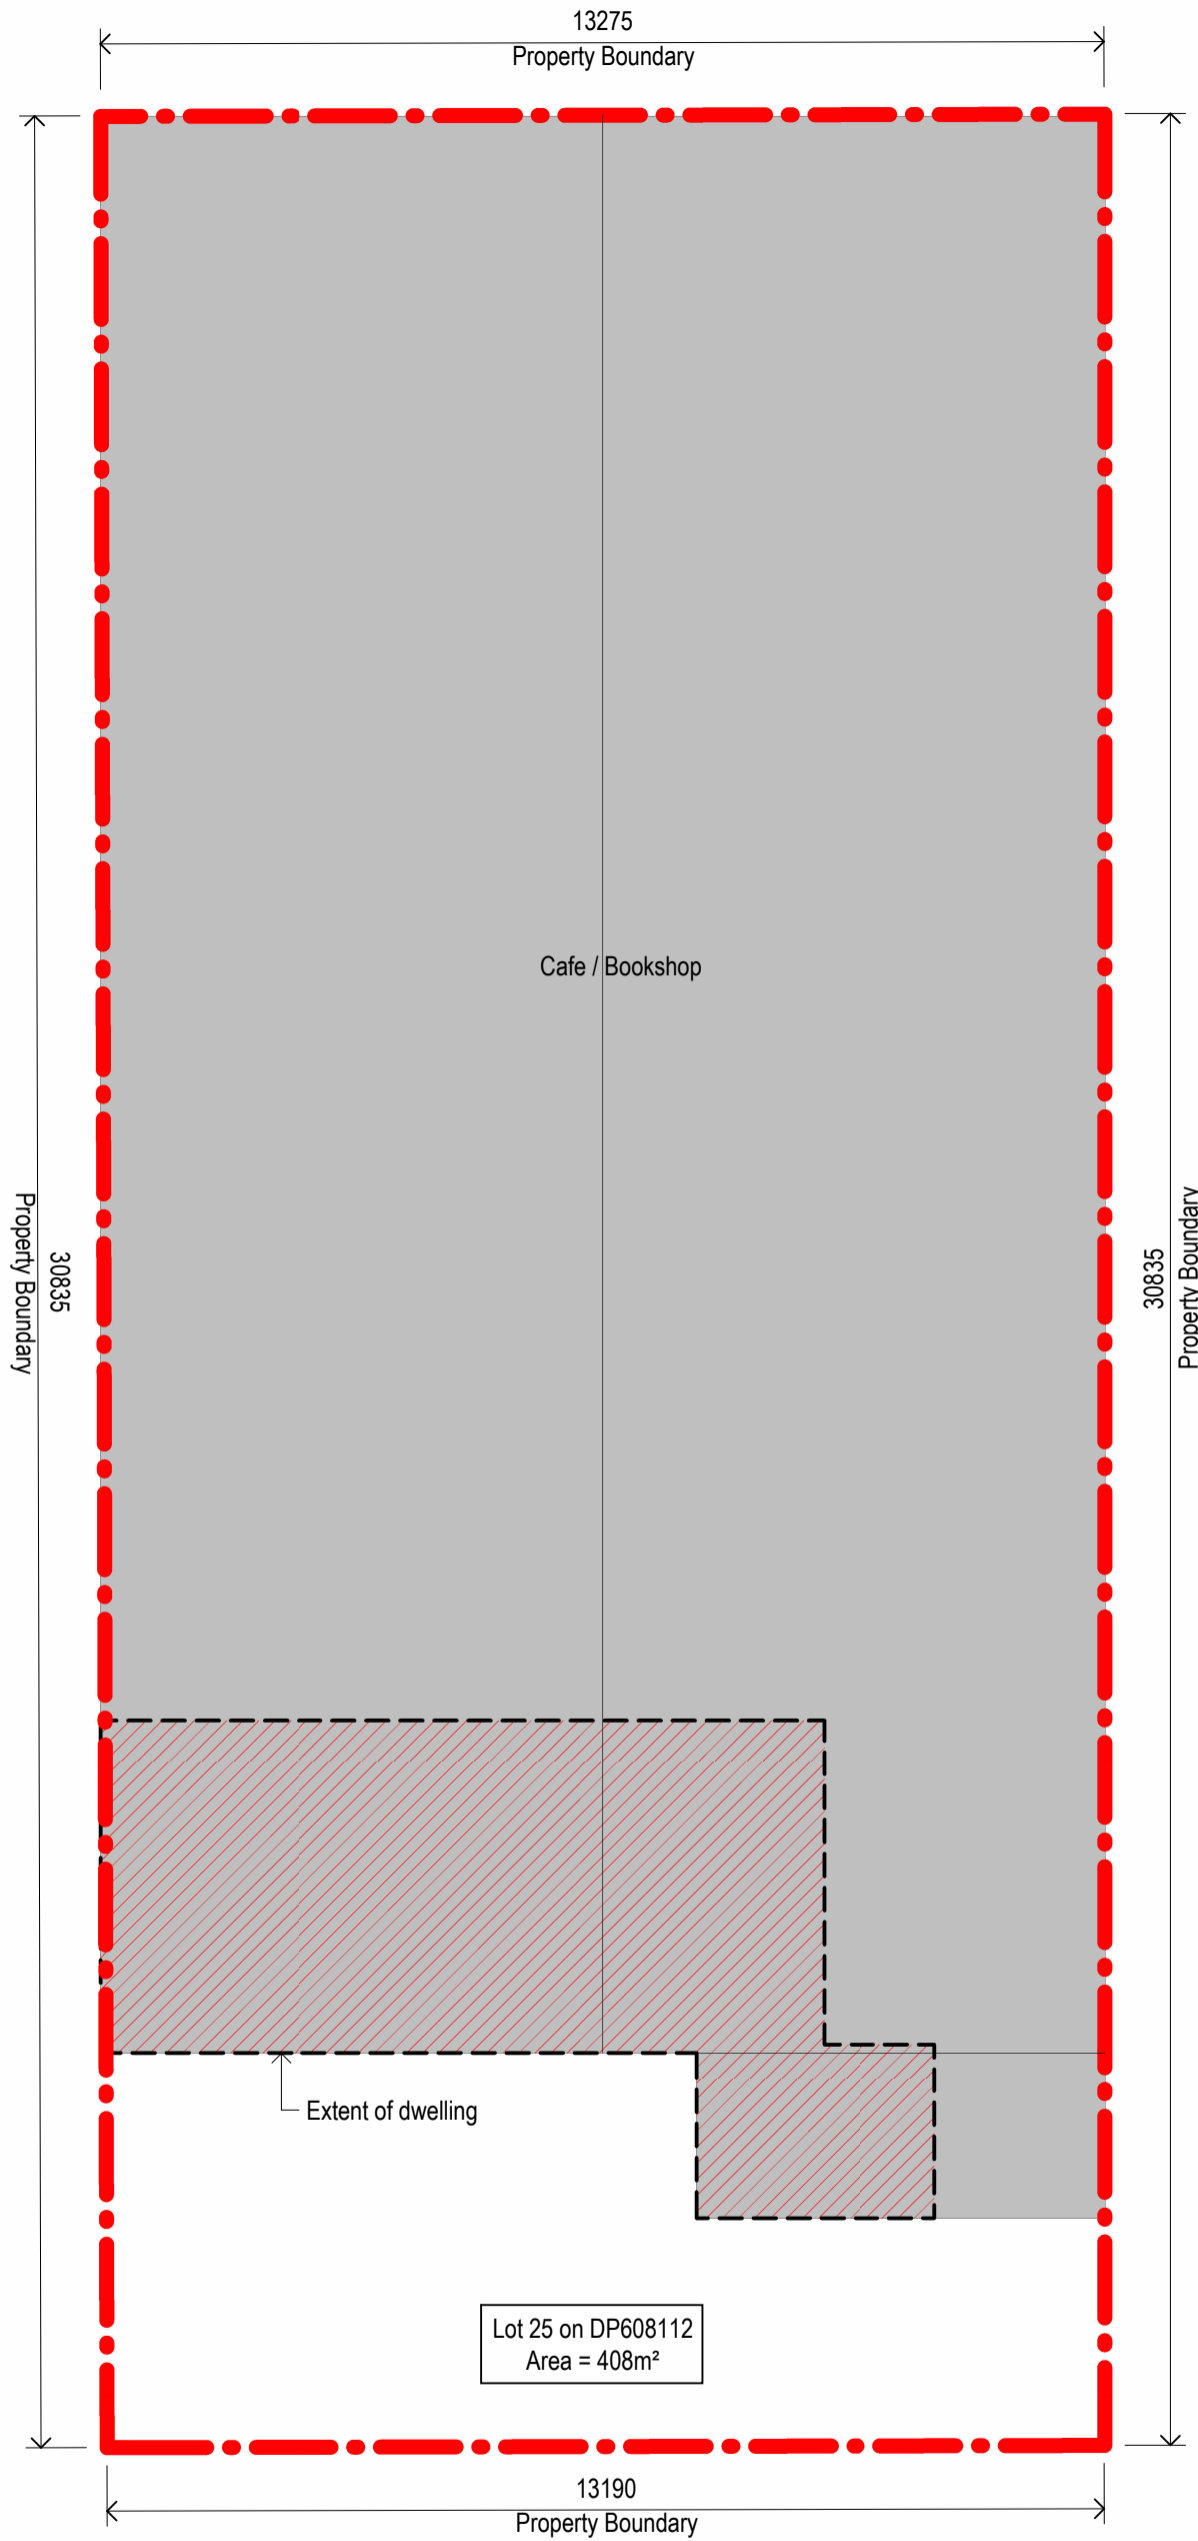

## 1 Site Plan

1 : 100

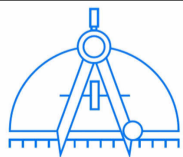

**MARSHALL**  
DRAFTING SERVICES  
20 Kuranda Avenue  
Armidale NSW 2350  
M: 0438 770 279  
E: marshalldrafting@gmail.com

No.	Description	Date
A	Client Issue	03.02.24
B	Client Issue	22.04.24

R. Burnet  
**As-built Attached Dwelling**  
46 Bridge Street  
Uralla NSW 2358

### Site Plan

Project Number	24015	WD-01	B
Date	03/02/2024		
Drawn by	C. Marshall	Scale	1 : 100
Checked by	C. Marshall		